

# MARION COUNTY SURVEYOR'S OFFICE

## SECTION CORNER RECORD

DEBRA S. JENKINS  
MARION COUNTY SURVEYOR


SEC. 15 TWN. 16<sub>N</sub> RNG. 5<sub>E</sub>

BRYAN F. CATLIN, PLS  
TECHNICAL SUPERVISOR

Date: 9-30-09  
Party Chief: Wilcoxen  
Crew: Finney  
Type of Marker: Harrison  
Method of Establishment: County: 5-8-2000  
IN S.P.C. E Zone, NAD 83  
Name: 16051506  
N: 509 140.598 0(m)  
E: 75 462.795 0(m)



42nd Street	4200 N	E. County Line Rd 12000 E	

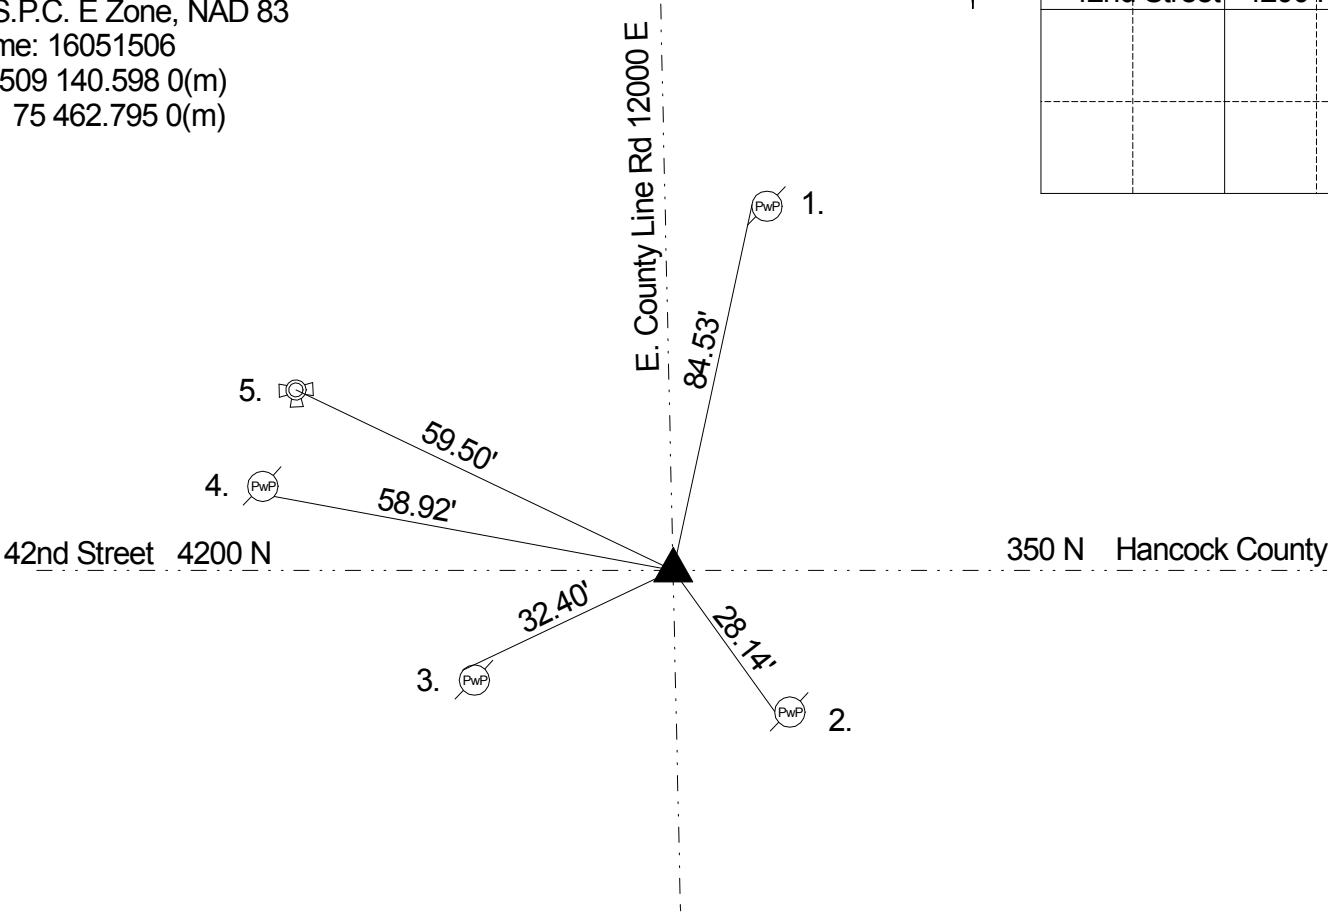

John Hendricks set post in 1820 with witnesses: Beech 11”dia. S 4 W 36 links, Beech 5” dia. S 45 E 13 links per pg 15 of the Marion County Atlas. 8-25&26-49 P. Hasbrook found 1 witness, witnesses unclear. 4-12-1866 Oliver W. Voorhis set stone on quarter post at E line per Lawrence Legal Survey book. 11-30-1949 Roxy Gioscio called a stone. 8-20-63 Burres called a pipe over stone 6” down. 5-14-70 McLand called a stone 6” down. 9-19-73 Hancock County Surveyors office (ties from Scherschel Eng. 1963) called brass plug and plate set above stone. 3-12-75 T. Fortner called a PK over stone 6” down. 8-14-81 Wilcoxen called a PK nail over stone 6” down. 8-01-88 Gries called a brass plug and plate set above stone. 6-9-95 Wilcoxen called a brass plug with a plate set over stone. 5-8-2000 Wilcoxen called same. 2-6-06 Wilcoxen called same. 9-23-09 Wilcoxen called it a brass plug with brass disc 3” down. Also found a gray granite stone 13” down, under brass plug with disc. Harrison set over stone.

REF.	DISTANCE	DESCRIPTION
1.	84.53'	PK nail W PwP #1-381 GB 12" up
2.	28.14'	Mag nail E PwP #23-421 GA 15" up
3.	32.40'	Mag nail NW PwP no # 15" up
4.	58.92'	Mag nail SE PwP #16-381 F 20" up
5.	59.50'	Top nut of fire hydrant